




TRO Location Plan 1:500

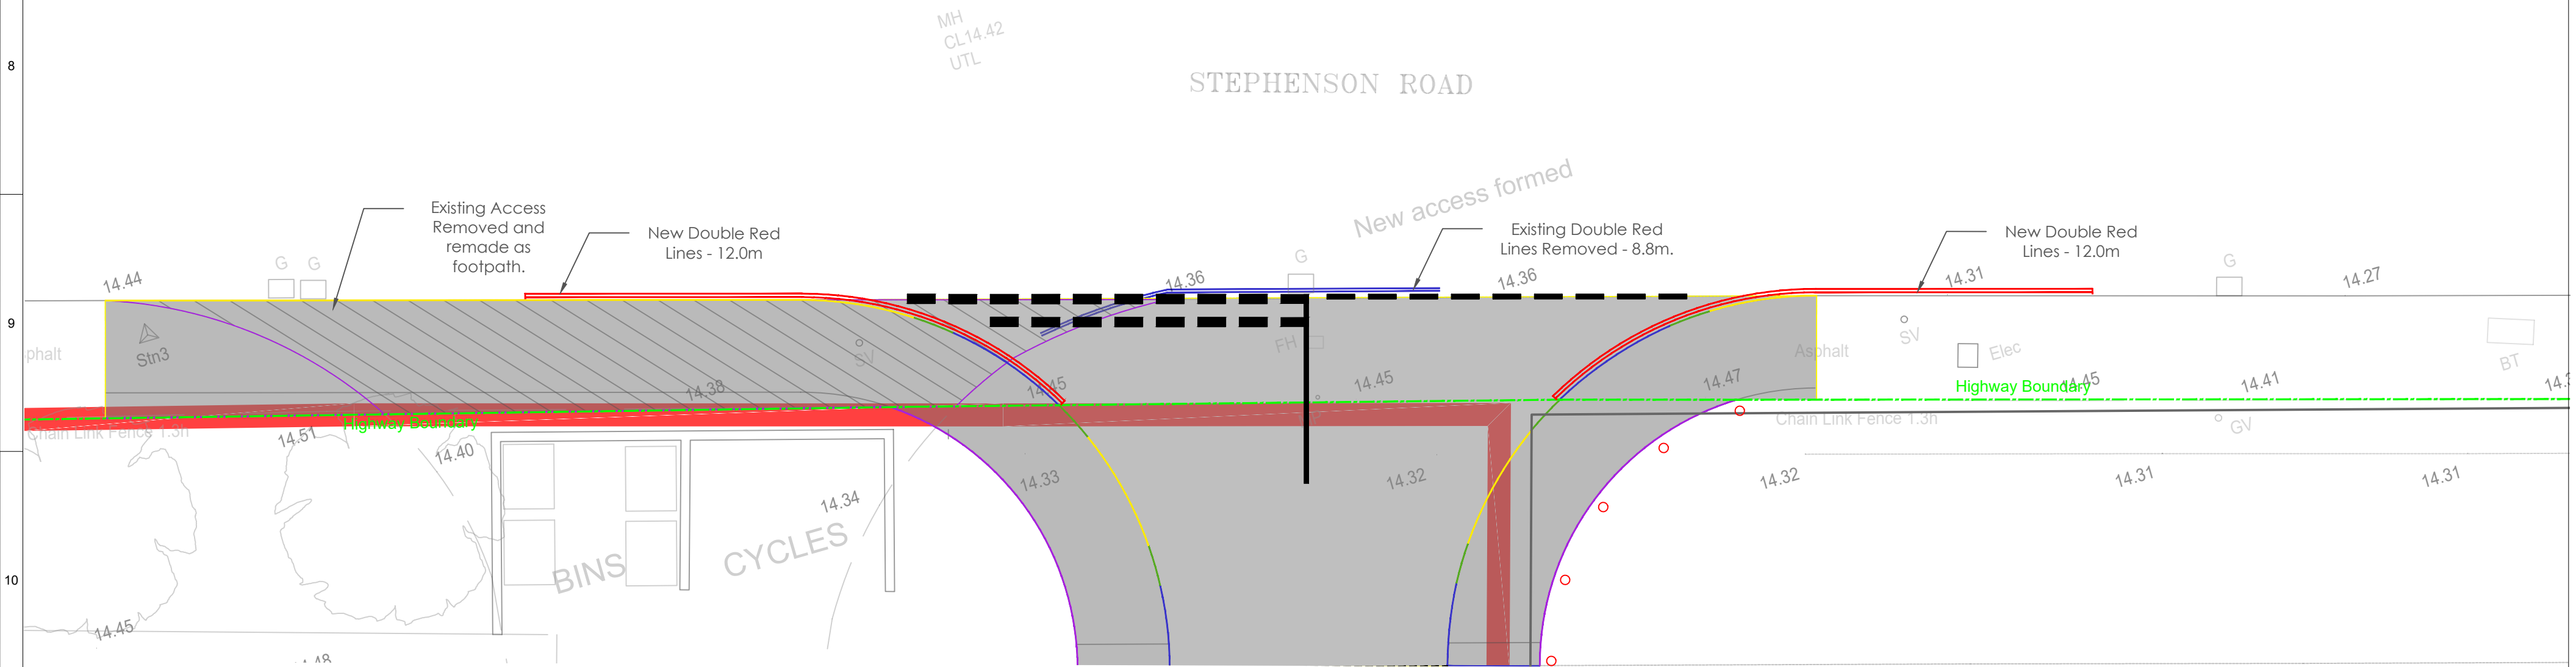


TRO Layout Plan 1:100

Key	
Highway Boundary:	<div></div>
New Macadam Foot Path	<div></div>
Existing Double Red Lines To Remain	<div></div>
New Double Red Lines	<div></div>
Existing Double Red Lines To Be Removed	<div></div>
BN Kerb	<div></div>
HB2 Kerb	<div></div>
Transition Kerb	<div></div>
Area of TRO	<div></div>

8.8m of existing double red lines to be removed (Shown Blue) around the east radius existing access which is being removed, new double red lines (Shown Red) to be extended both sides of the new access in to the vehicle crossing up to the highway boundary.

F			
E			
D			
C			
B			
A			
Rev.	Date	Initials	Details Of Revision

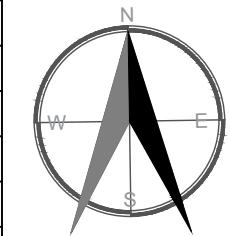

C.E.B.A.S.S. CIVIL ENGINEERING BUILDING AND SURVEYING SERVICES 13 Cliff Road Holland on sea Essex, CO159QQ. Tel:01255 814174 Email: Djackaman@gmail.com				
PROJECT	TRO Layout			This drawing, its contents and associated properties are the property of CEBASS (Civil Engineering, Building and Surveying Services). No unauthorised reproduction is permitted without prior written consent by the management.
ADDRESS	11 Stephenson Road Gorse Lane Industrial Estate Clacton on sea Essex CO15 4XA			
Project No.	07/21-19		Drawing No.	07.21-19.008
Drawn	SRJ	Checked	Approved	Date 01st August 2022
Scale				1:100