



Apparatus Plan -example – Please add Drawing number.

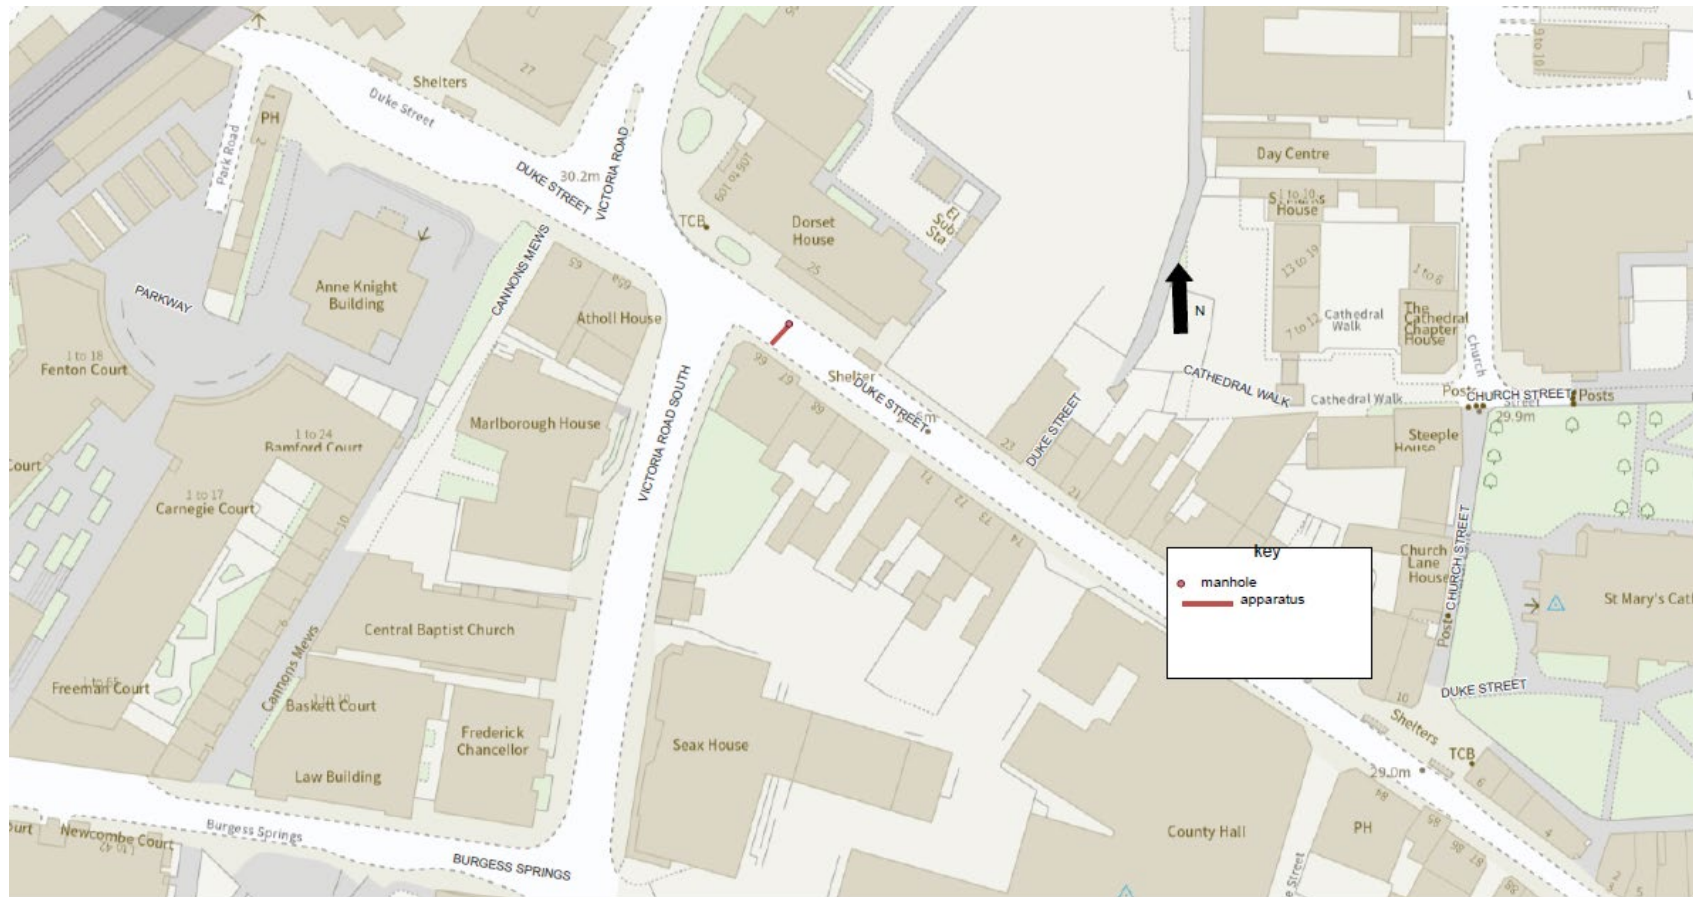

26/06/2025, 16:13:04

Road Labels

1:827

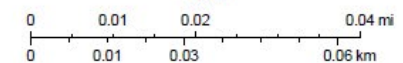

Site plan - example - please add Drawing number.



26/06/2025, 16:17:43

Road Labels

